



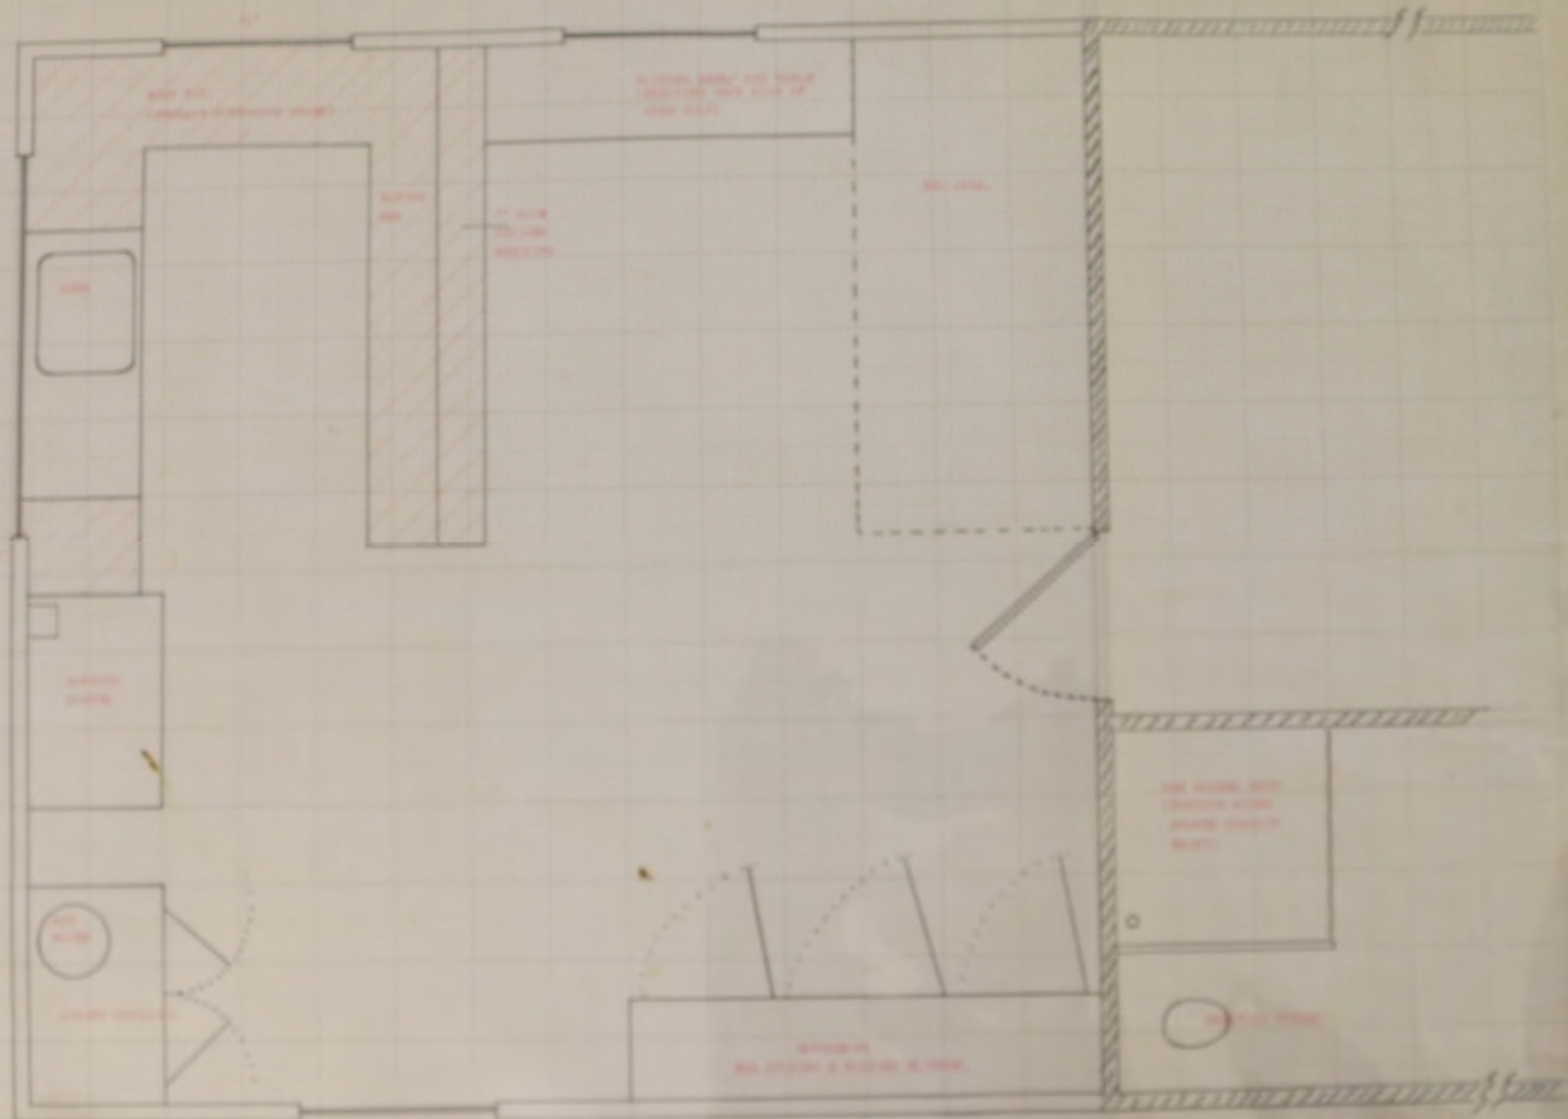


RECOMMENDED LAYOUT OF QUARTERS TO BE USED IN THE FUTURE. ALL  
THE AREAS ARE TO BE USED IN THE FUTURE.

HOUSE FOR EXPORT TO THE FALKLAND ISLANDS FOR MESSRS. REED & CO. LTD.  
 SCALE: FOUR FEET TO ONE INCH

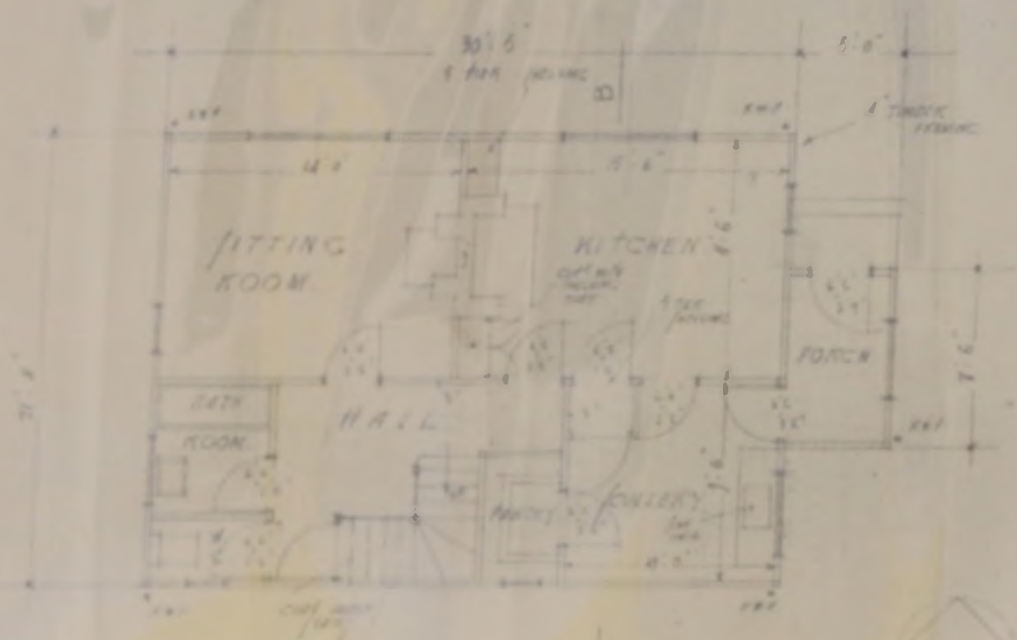

GROUND FLOOR PLAN

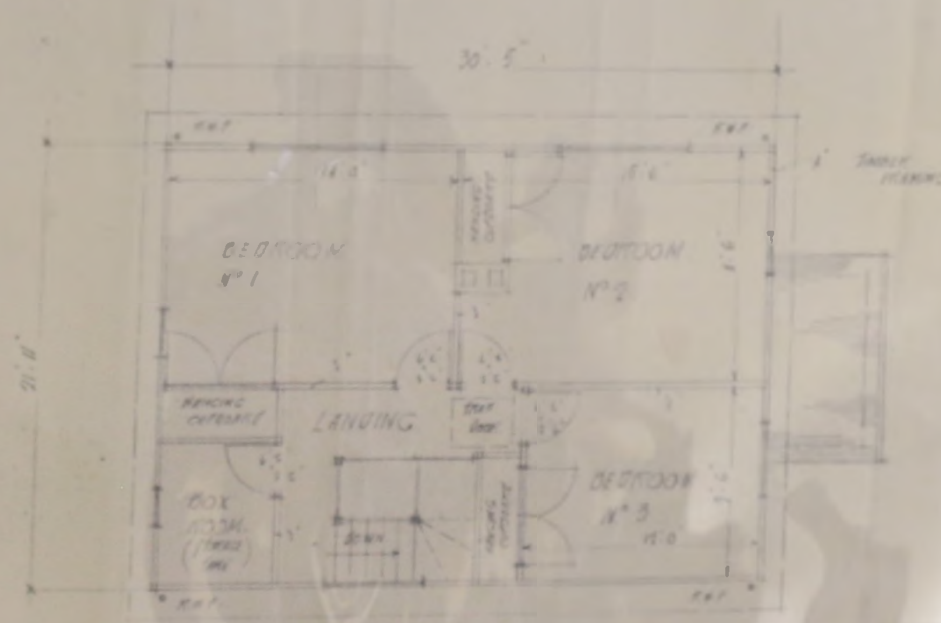

FIRST FLOOR PLAN

DEAWING



HOUSE FOR EXPORT TO THE FALKLAND ISLANDS - FOR MR. J. J. FARMER LTD. & CO. LTD.

SCALE: FOUR FEET TO ONE INCH


WINDING GEAR  
COT. JAW ON  
SHEAVE  
FELT AND  
1" RUBBER BANDS

DAY BOX  
GATE

4" x 6" (10' x 12')  
10' x 12' (10' x 12')  
6" x 12' (10' x 12')


4" x 6" (10' x 12')  
10' x 12' (10' x 12')

1" x 1" (10' x 12')

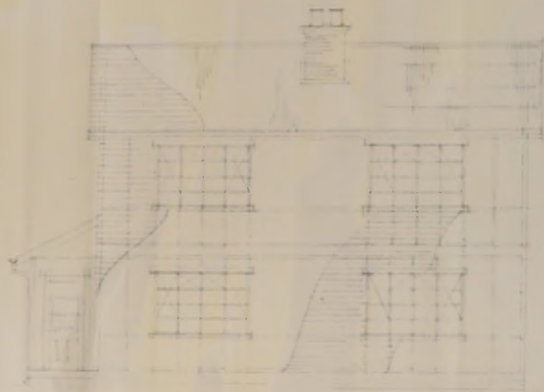


NORTH ELEVATION

10' x 12' (10' x 12')  
10' x 12' (10' x 12')

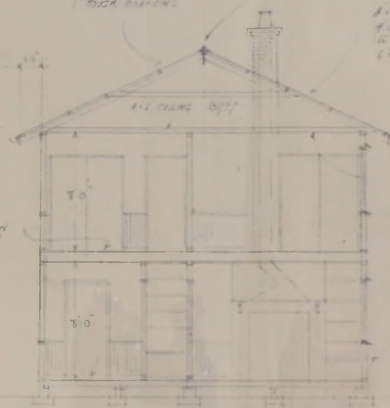

SECTION A-C

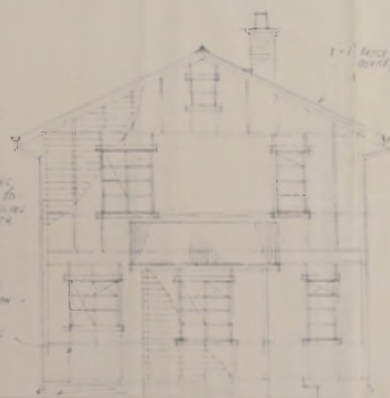

EAST ELEVATION

WILLIAM HARRISON LTD.  
ARCHITECTS & ENGINEERS  
10, ABINGDON ROAD, LONDON, S.W. 8

DESIGNED BY T. J. J.



WARNING

WARNING  
PURPLE GRID REFERS TO UTM ZONE 21 GRID


FOX BAY

SELECTED UPDATE DATA OVERPRINTED IN MAGENTA.

**WARNING**

RED GRID REFERS TO UTM ZONE 20 GRID  
AND MUST BE USED IN CONJUNCTION WITH  
SCALE 1:250,000 SERIES 1501/1501A

SERIES 1000000000  
SHEET 1000000000  
EDITION 2000000000

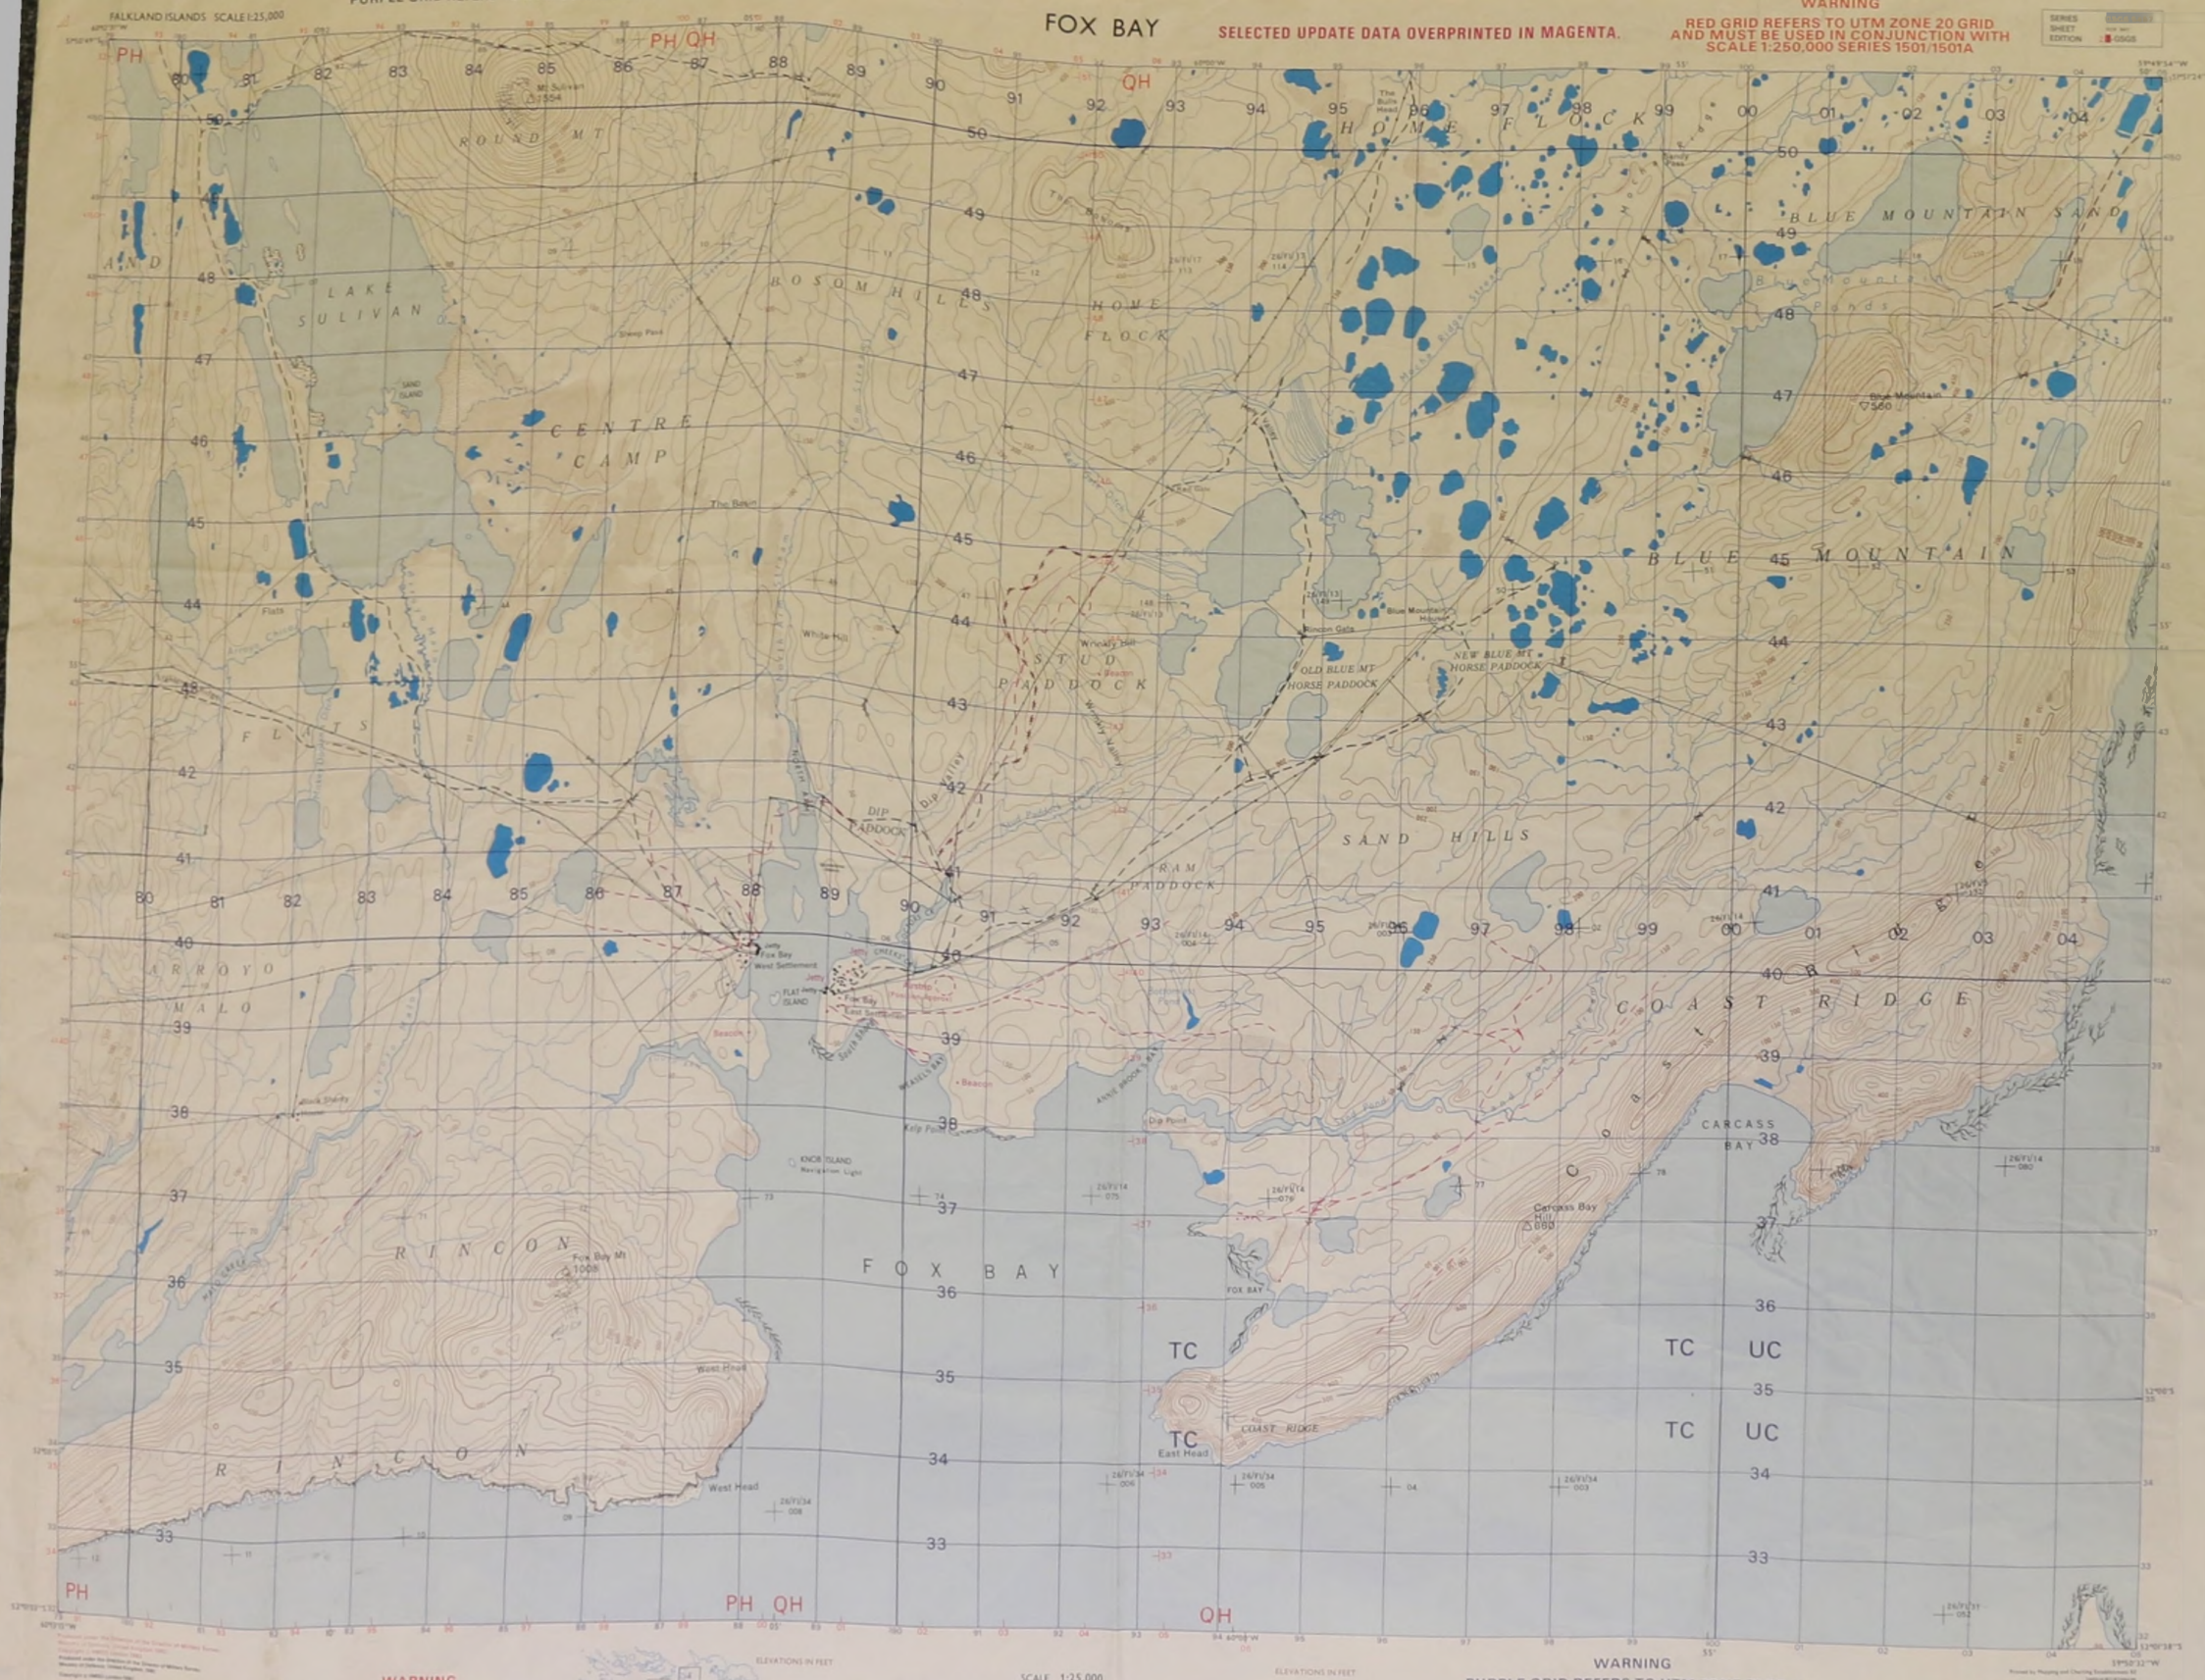

**WARNING**


RED GRID REFERS TO UTM ZONE 20 GRID  
AND MUST BE USED IN CONJUNCTION WITH  
SCALE 1:250,000 SERIES 1501/1501A

SELECTED UPDATE DATA OVERPRINTED IN MAGENTA

**WARNING**  
PURPLE GRID REFERS TO UTM ZONE 21 GRID

SERIES GGGG 5457  
SHEET 104 of 107  
EDITION 2000



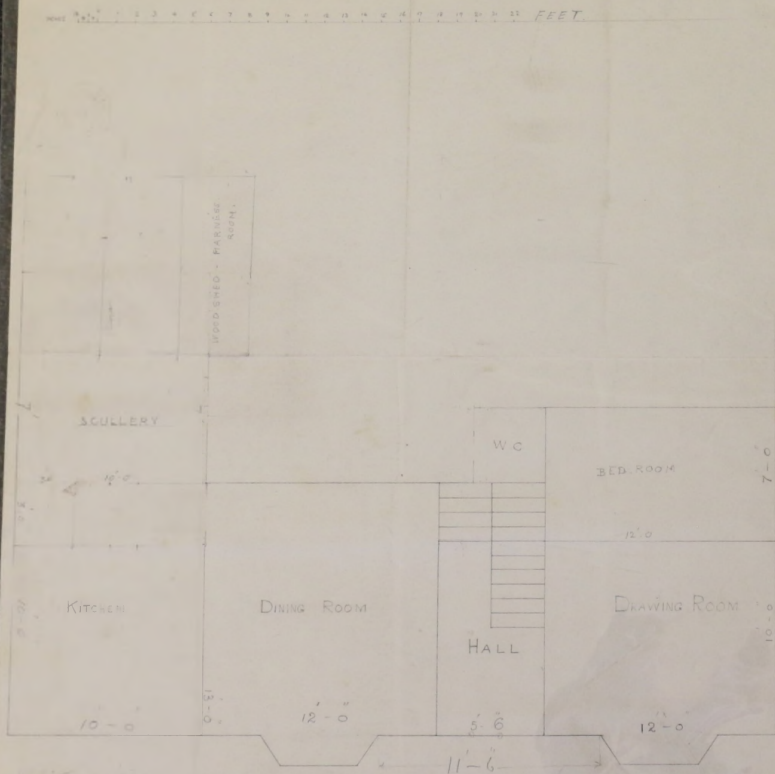

Stipendiary Magistrate's House (2nd Floor) 6/6

PROPOSED IMPROVEMENTS AT FOX BAY




Q<sup>o</sup> OF O & W STATION AS EXISTING



PART OF CARETAKER'S Q<sup>o</sup> AS EXISTING



Q<sup>o</sup> OF O & W STATION AS ALTERED

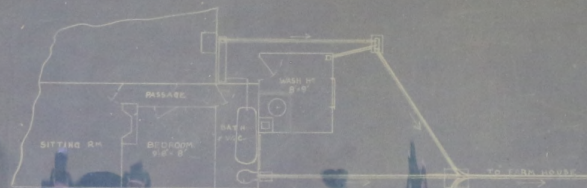

PART OF CARETAKER'S Q<sup>o</sup> AS ALTERED




DRAINS & SEWER FROM Q<sup>o</sup> OF O & W ST. & CARETAKER.





FOX BAY WATER SUPPLY  
SUPPLEMENTARY TANK.

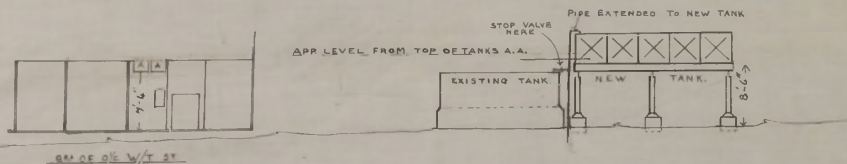

ELEVATION



PLAN

SCALE 1/8" = 1'

3/4" PIPE TO 6" OF O.K. W/T ST.

3/4" PIPE TO 6" OF O.K. W/T ST.



TO CASERTNER'S

*Left end of Fox Bay  
water supply*


*20' 45" 1'*




FARMING - FOX BAY EAST - FOX BAY STATION... - 8413 -

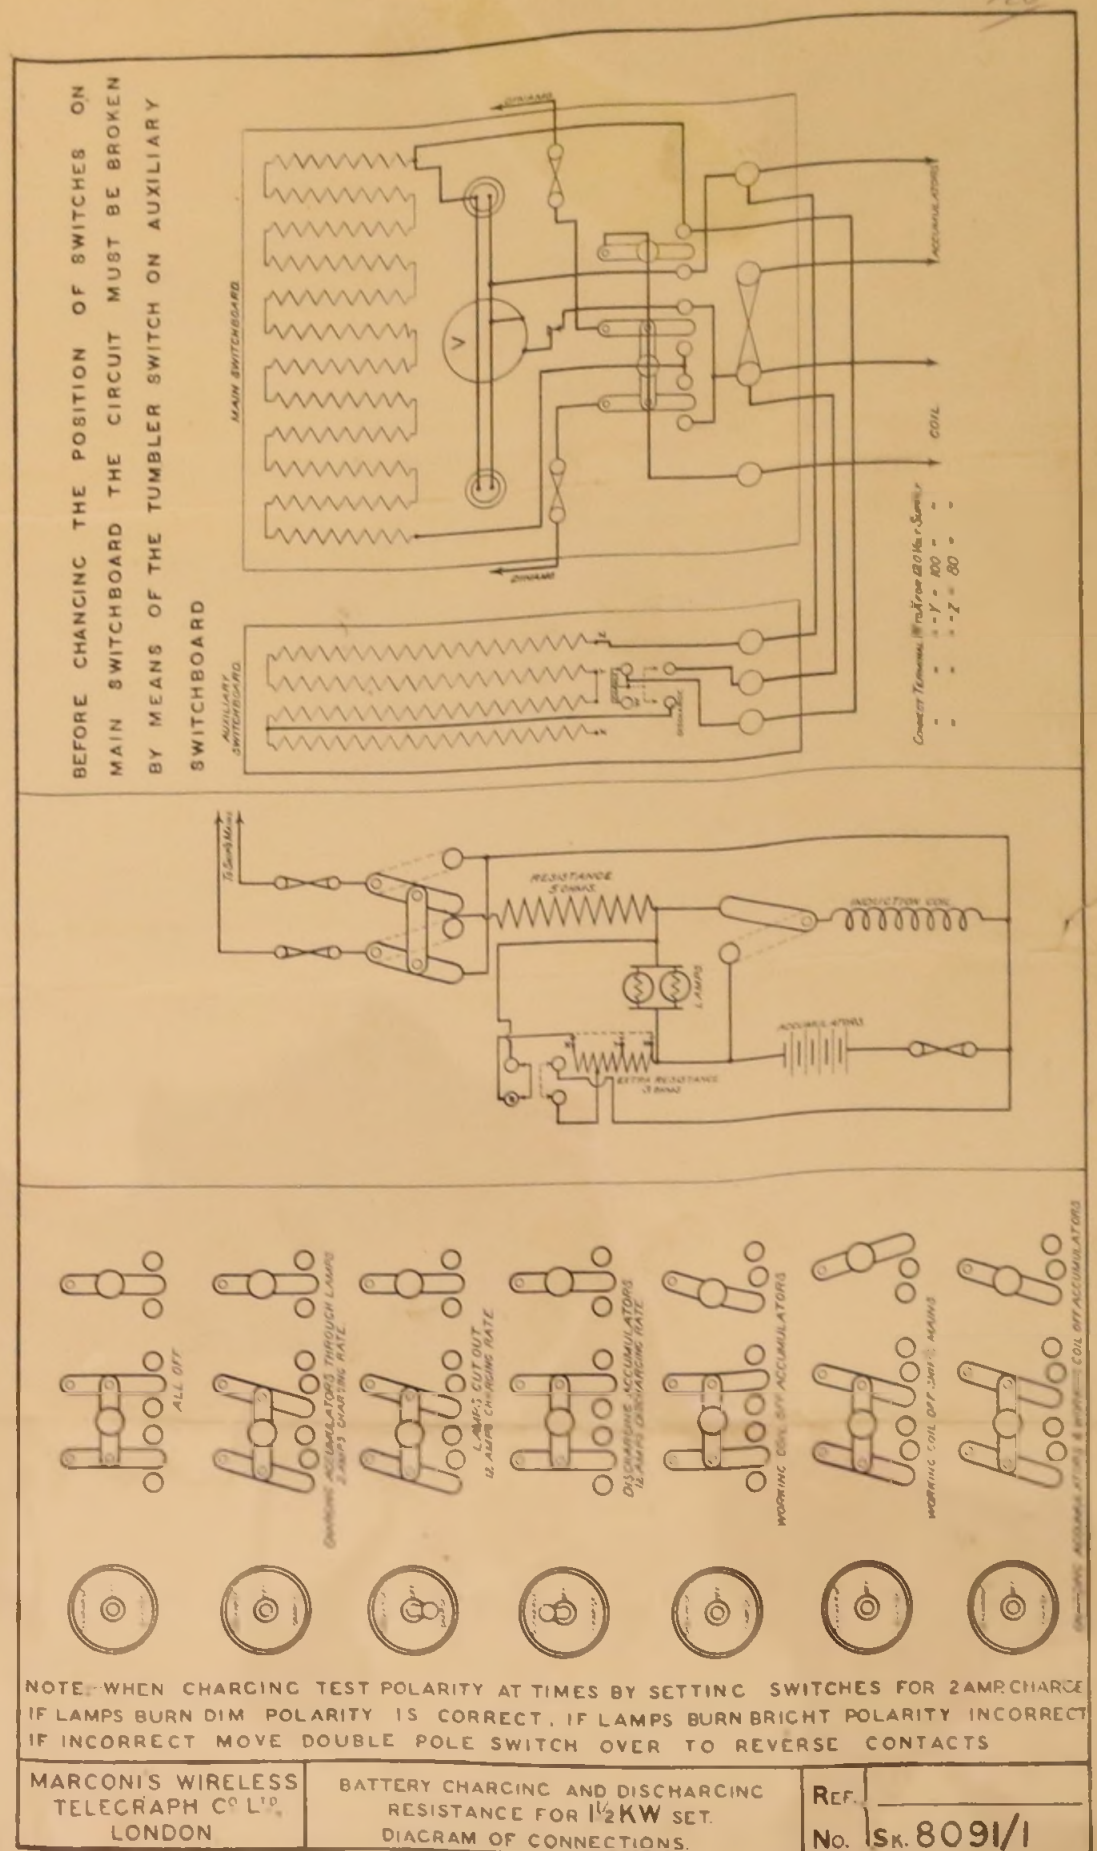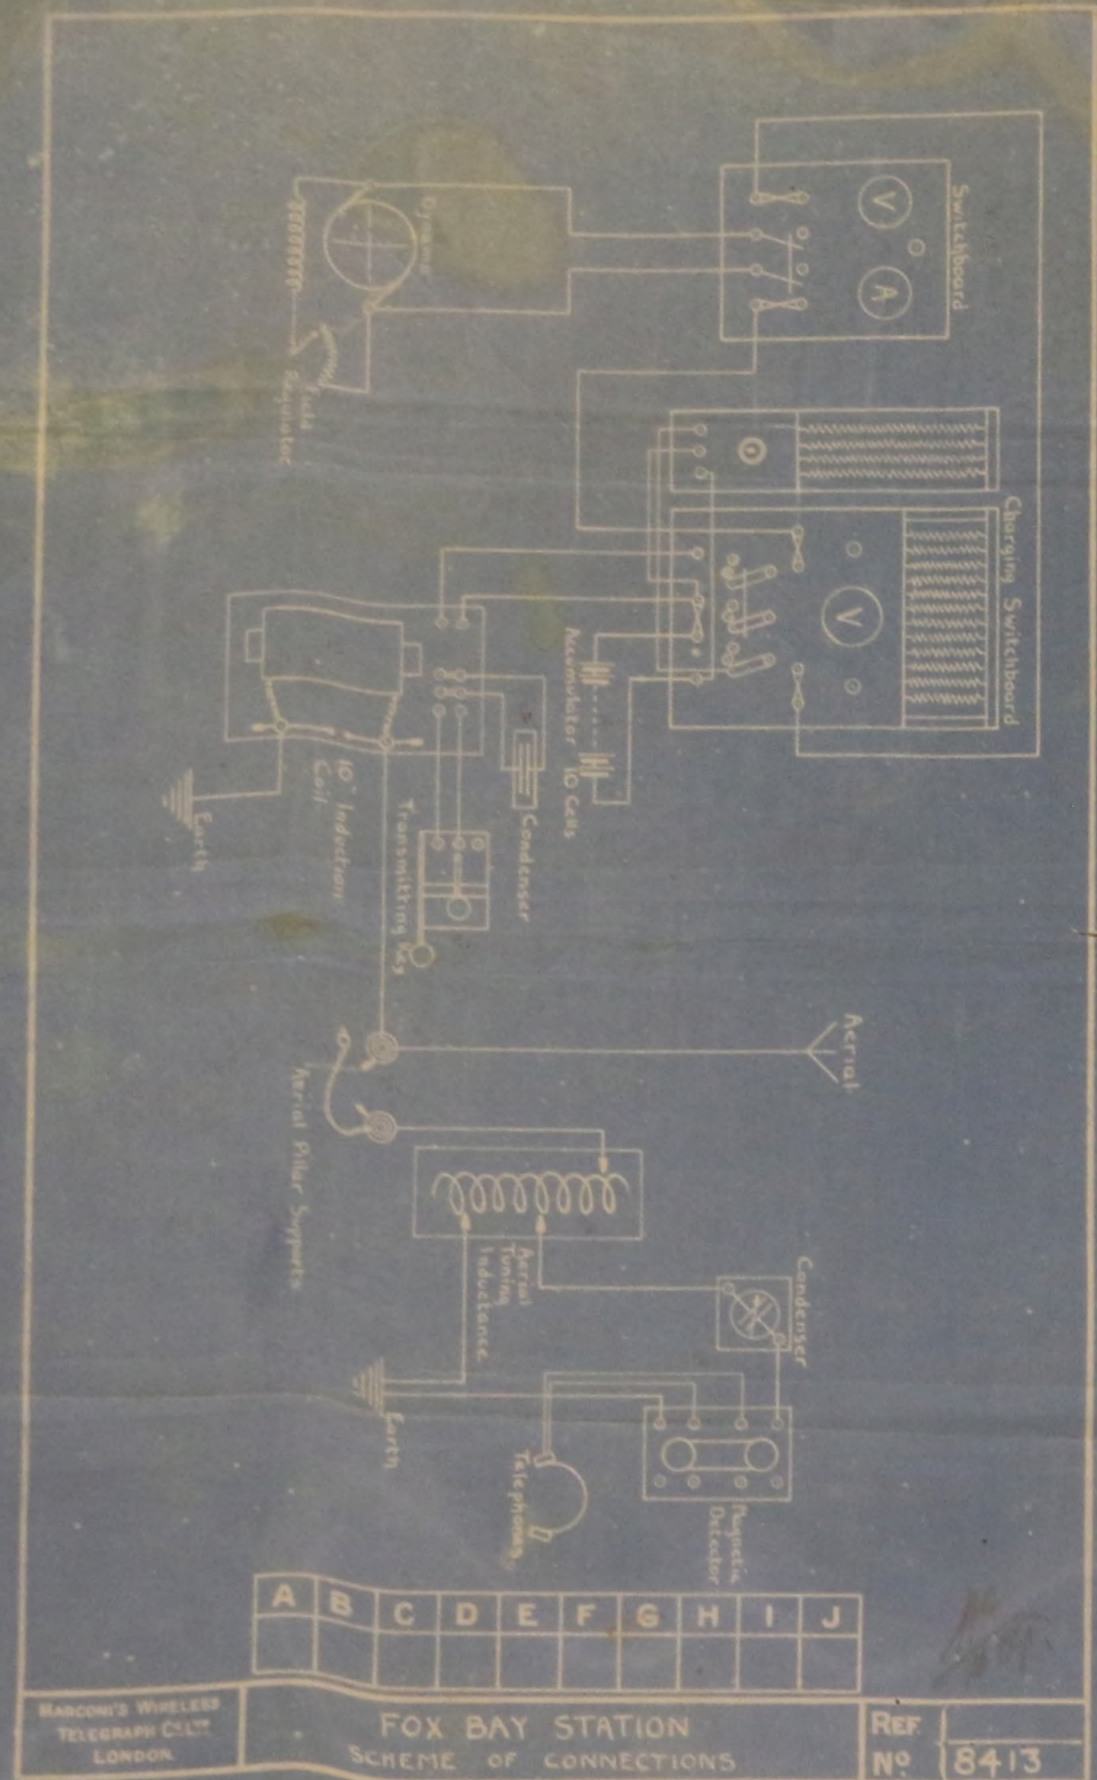



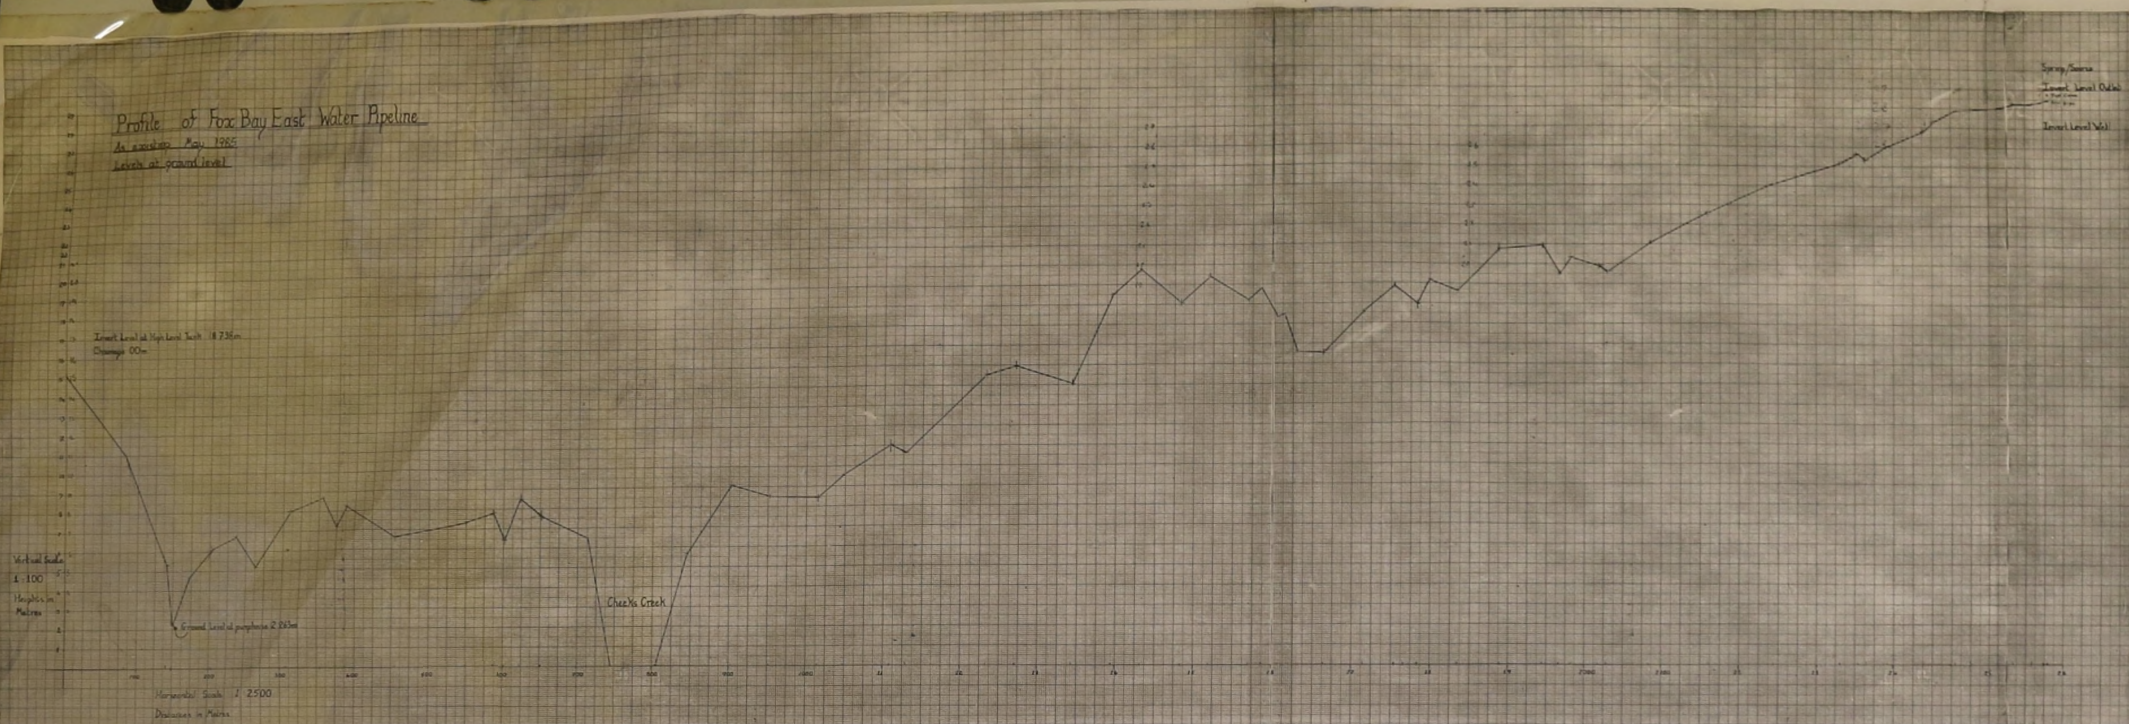

Fox Bay East Water Pipeline  
Horizontal Alignment  
As Existing May 1985  
Scale 1:2500

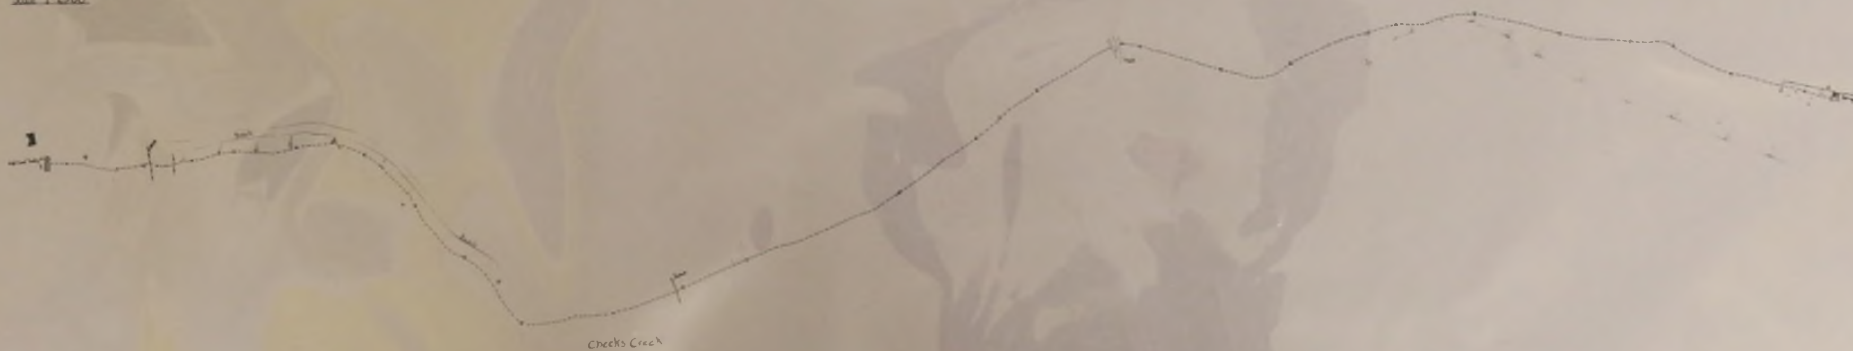

DATE: 1/1/85

AMENDMENTS

Fox Bay East

Water Pipeline


DATE: 1/1/85

As Shown: 4/85

Public Works Dept.



LONGITUDINAL SECTION FOR PROPOSED SEWER SCALES-HORIZONTAL 1:1000  
VERTICAL 1:200

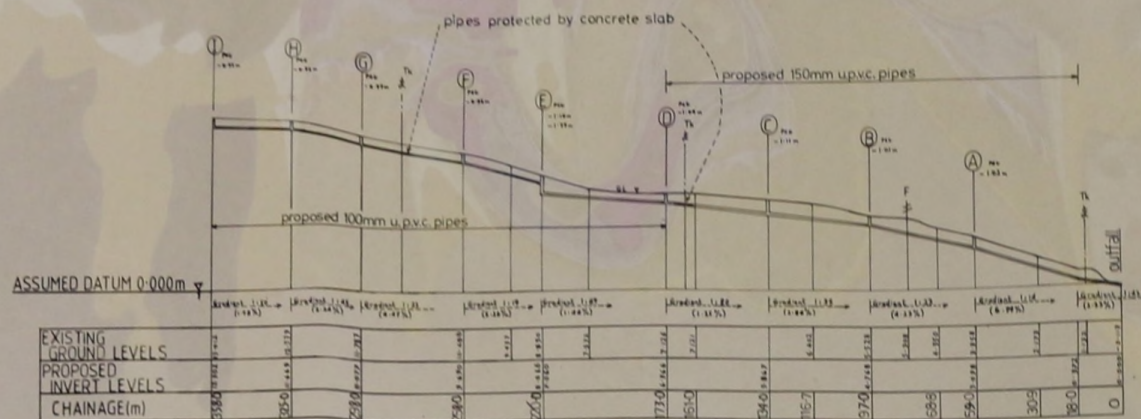

DETAILS, BACKDROP MANHOLE 'E'

SEWER TRENCH

SEWER OUTFALL

(SEE DRWG. NO. P.W.D. 902/100) -  
(ON FILE)



FOX BAY EAST.  
NEW SEWERAGE FACILITIES

AS BUILT SEWER  
EXISTING SEWERS

| AMENDMENTS                                                                                                                                                                                                              | SCALE: | DATE:     | PLAN NO.         |
|-------------------------------------------------------------------------------------------------------------------------------------------------------------------------------------------------------------------------|--------|-----------|------------------|
| 1. Sewer level @ 'C' changed from 1.117m<br>Existing & new level @ 'F' changed from 1.100m<br>to 1.117m only<br>But level may be more. Check above on long section.<br>Sewer line @ 'B' must be in road bed.<br>15/4/86 | 1:1250 | 15/4/1986 | P.W.D. 902 / 100 |
| DRAWN DAC,                                                                                                                                                                                                              |        |           |                  |





**NOTES:**  
 1. Foundation, Machinery (and Instruments, etc.) shall be mounted on the existing foundation.  
 2. Layout to be in accordance with the drawings and the design of the machinery.  
 3. Refer to the drawings for details of the machinery and the design of the machinery.

**NOTES:**  
 The design of the building, structure and machinery shall be in accordance with the design of the machinery and the design of the machinery.  
 The design of the building, structure and machinery shall be in accordance with the design of the machinery and the design of the machinery.

CROSS SECTIONAL ELEVATION THRU A-A

PLAN VIEW

PRICE CARDEW ANDER  
 CONSULTING ENGINEERS  
 5510 QUEEN ANNES GATE  
 LONDON, S.W. 1

Rooming No. 5197  
 Date: 20

Technical drawing of the building  
 showing the layout of the building  
 and the design of the machinery.

Scale: 1/4" = 1'-0"

DRAWING No. 7974

March 1948